


SELECT DRAWINGS

(FOR REFERENCE ONLY)


**Construction works related to Bus Stations on
High capacity Bus system on Ambedkar Nagar –
Delhi Gate Corridor in Delhi**

Package-1: Ambedkar Nagar Jn. to Press Enclave Jn.


As-built Drawings

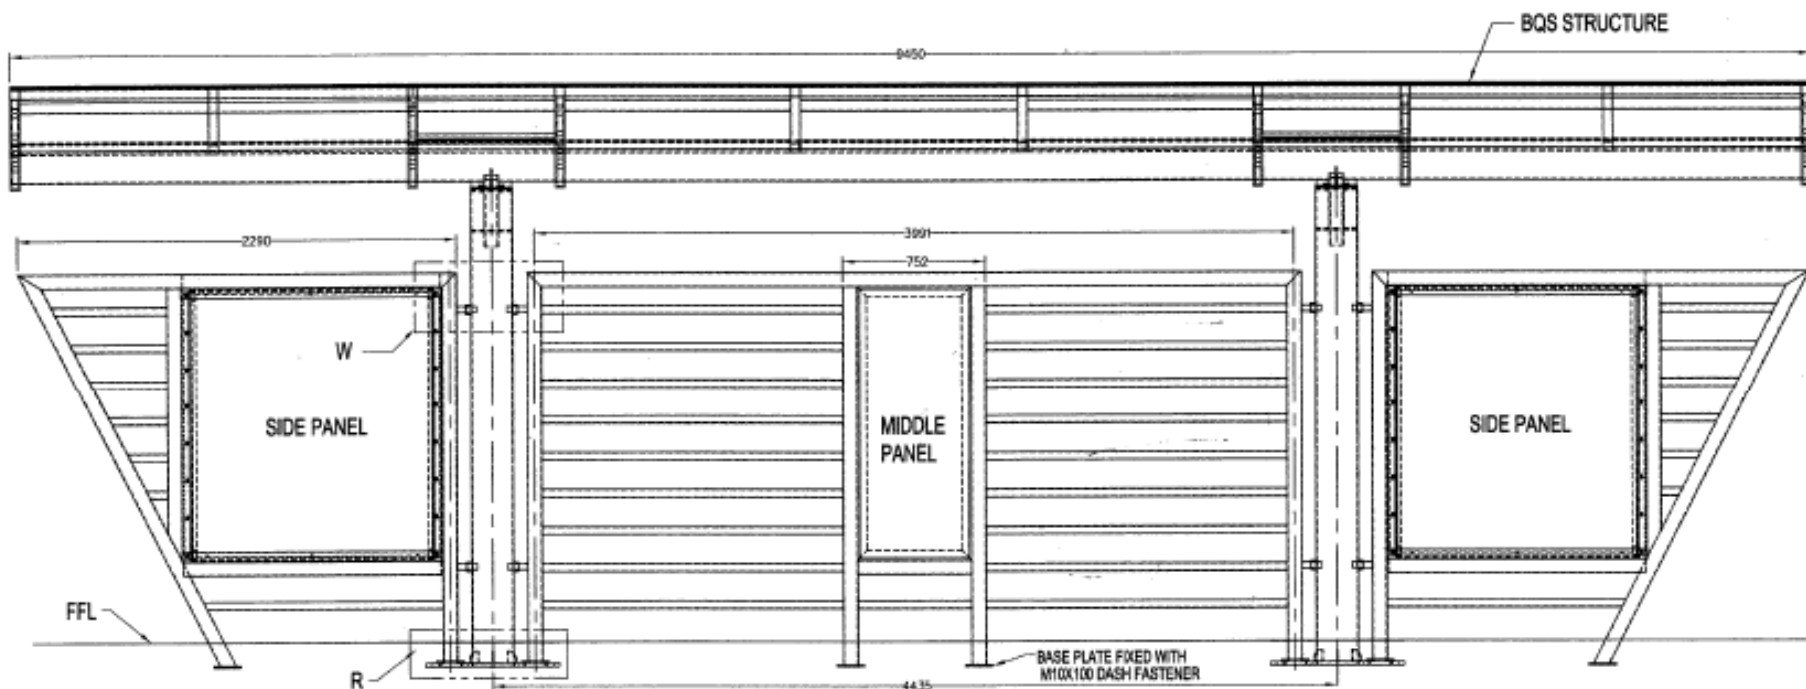

ELEVATION
SCALE 1:25

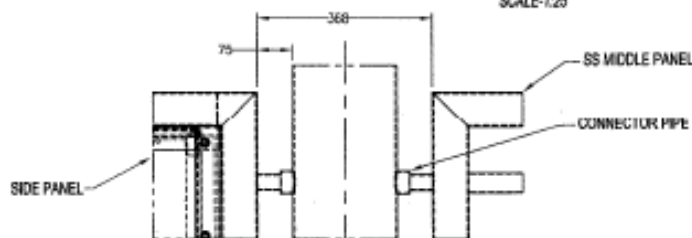

DETAIL W
SCALE 1:10





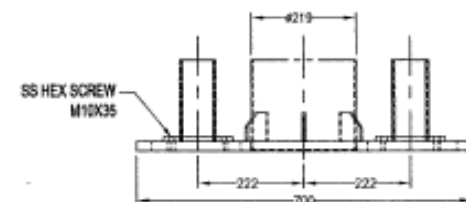










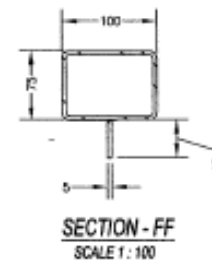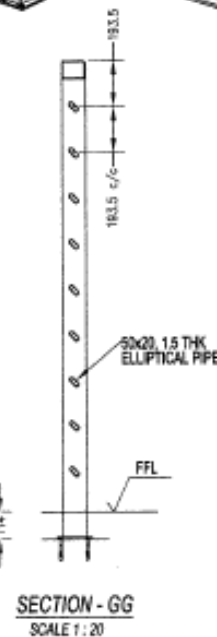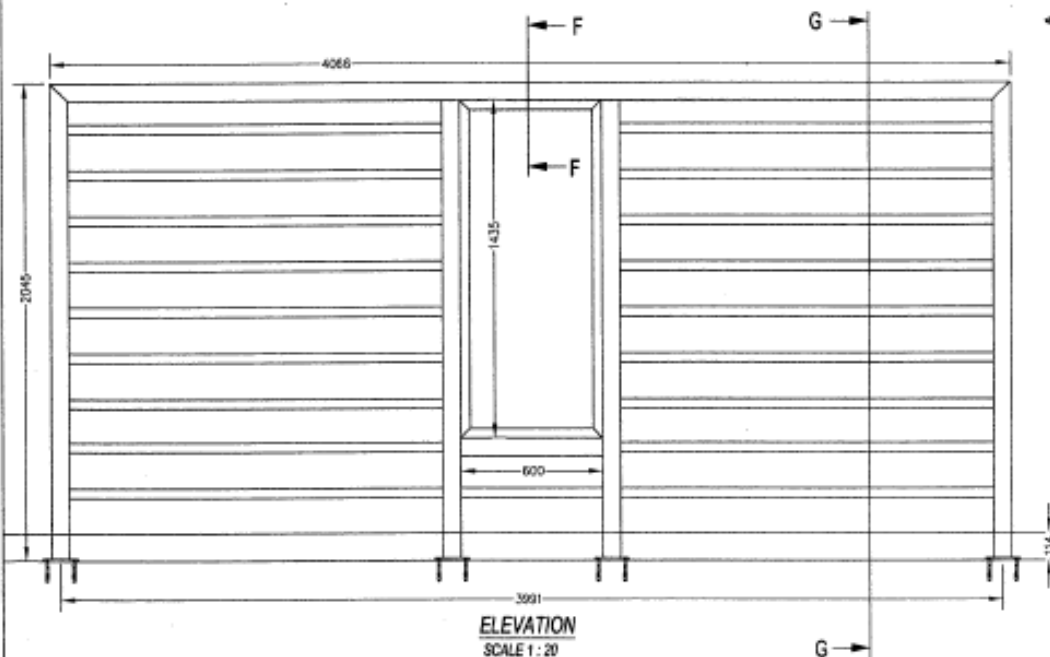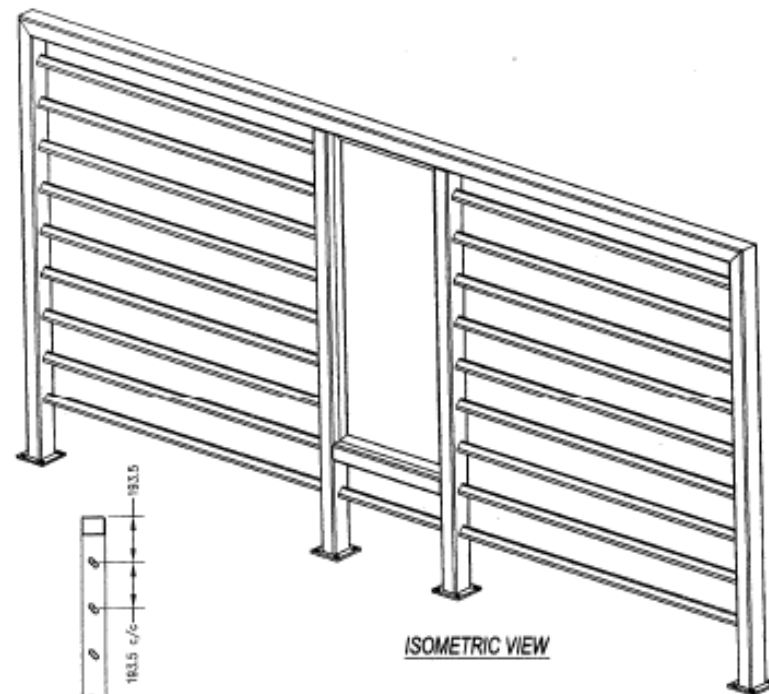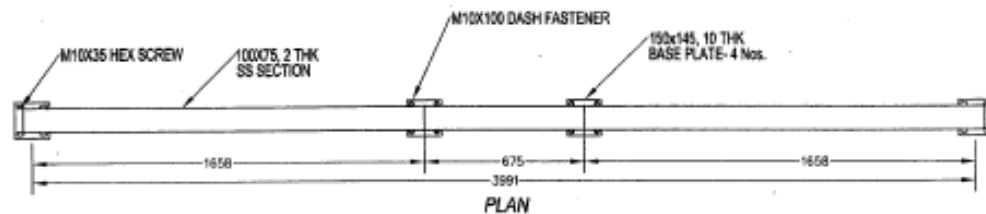


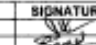








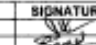


DETAIL R
SCALE 1:10


BQS ASSEMBLY
SCALE 1:25

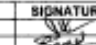NOTE- ALL DIMENSIONS IN mm OR STATED OTHERWISE


| PLANNING / DESIGN | PROJECT MANAGEMENT CONSULTANT | CONTRACTOR | DRG. TITLE: BQS STRUCTURE - ASSEMBLY DETAILS | TRANSPORT DEPARTMENT | |
|---|---|---------------------------------|---|--|-------------------|
| TRIPP INDIAN INSTITUTE OF TECHNOLOGY, HAUZ KHAS NEW DELHI- 110016 | RITES LIMITED (Schedule "W" Enterprise of Govt of India) TRANSPORT INFRASTRUCTURE DIVISION RITES SHAWAN, PLOT NO.1 SECTOR-28, GURGAON-122001 (HARYANA) Website: www.rites.com | JINDAL Architecture Ltd. | DRAWING NO:- JAL/BRT/AN-DG/BQS(PKG-1)/AS-BUILT/5 | (GOVERNMENT OF NCT DELHI) | DIMTS LTD. |
| CHECKED BY SATYENDRA, MGR / TI | CHECKED BY SATYENDRA, MGR / TI | PREPARED BY VIVEK TRIPATHI | SHEET NO:- 1 of 8 | Project Title : CONSTRUCTION WORKS RELATED TO BUS STATION ON HIGH CAPACITY BUS SYSTEM ON AMBEDKAR NAGAR-DELHI GATE CORRIDOR IN DELHI (PACKAGE-1: AMBEDKAR NAGAR Jn. - PRESS ENCLAVE Jn.) | |
| APPROVED BY B.S.SEHRAWAT, AGM / TI | APPROVED BY B.S.SEHRAWAT, AGM / TI | CHECKED BY PANKAJ SAXENA | DATE:- 28/01/2009 | | |
| | | SUBMITTED BY SANJEEV PANDEY | SCALE :- Mentioned with Elements | | |




| | | | | | | | | | | | | | | | | | | | | | | | | | | | | | | |
|--|---|--|--|--|---|--|--|------------|---------------------|---|-------------|-------------------------|---|--|--|------|-----------|-------------|----------------|--|------------|---------------|--|--------------|----------------|--|---|--|--|--|
| PLANNING / DESIGN | PROJECT MANAGEMENT CONSULTANT | | CONTRACTOR | | DRG. TITLE: BQS STRUCTURE- MIDDLE PANEL | TRANSPORT DEPARTMENT (GOVERNMENT OF NCT DELHI) |  DIMTS LTD. | | |  INDIAN INSTITUTE OF TECHNOLOGY,HAUZZKHAS NEW DELHI- 110016 |  RITES LIMITED <small>(Schedule "A" Enterprise of Govt of India)</small> TRANSPORT INFRASTRUCTURE DIVISION UNITES BHAWAN, PLOT NO.1 SECTOR-29, GURGAON-122001 (HARYANA) Website:- www.rites.com |  JINDAL Architecture Ltd. |  | DRAWING NO:- JAL/BRT/AN-DG/BQS(PKG-1)/AS-BUILT/5 | SHEET NO:- 5 of 6 DATE:- 28/01/2009 SCALE :- Mentioned with Elements | | | | <table><tr><td></td><td>NAME</td><td>SIGNATURE</td></tr><tr><td>CHECKED BY</td><td>R.N. SINGH, AM / TI</td><td></td></tr><tr><td>CHECKED BY</td><td>SATYENDRA, MGR / TI</td><td></td></tr><tr><td>APPROVED BY</td><td>B.S. SEHRAWAT, AGM / TI</td><td></td></tr></table> | | NAME | SIGNATURE | CHECKED BY | R.N. SINGH, AM / TI |  | CHECKED BY | SATYENDRA, MGR / TI |  | APPROVED BY | B.S. SEHRAWAT, AGM / TI |  | <table><tr><td></td><td>NAME</td><td>SIGNATURE</td></tr><tr><td>PREPARED BY</td><td>VIVEK TRIPATHI</td><td></td></tr><tr><td>CHECKED BY</td><td>PANKAJ SAXENA</td><td></td></tr><tr><td>SUBMITTED BY</td><td>SANJEEV PANDEY</td><td></td></tr></table> | | NAME | SIGNATURE | PREPARED BY | VIVEK TRIPATHI |  | CHECKED BY | PANKAJ SAXENA |  | SUBMITTED BY | SANJEEV PANDEY |  | Project Title : CONSTRUCTION WORKS RELATED TO BUS STATION ON HIGH CAPACITY BUS SYSTEM ON AMBEDKAR NAGAR-DELHI GATE CORRIDOR IN DELHI (PACKAGE-1: AMBEDKAR NAGAR Jn. - PRESS ENCLAVE Jn.) | | | |
| | NAME | SIGNATURE | | | | | | | | | | | | | | | | | | | | | | | | | | | | |
| CHECKED BY | R.N. SINGH, AM / TI |  | | | | | | | | | | | | | | | | | | | | | | | | | | | | |
| CHECKED BY | SATYENDRA, MGR / TI |  | | | | | | | | | | | | | | | | | | | | | | | | | | | | |
| APPROVED BY | B.S. SEHRAWAT, AGM / TI |  | | | | | | | | | | | | | | | | | | | | | | | | | | | | |
| | NAME | SIGNATURE | | | | | | | | | | | | | | | | | | | | | | | | | | | | |
| PREPARED BY | VIVEK TRIPATHI |  | | | | | | | | | | | | | | | | | | | | | | | | | | | | |
| CHECKED BY | PANKAJ SAXENA |  | | | | | | | | | | | | | | | | | | | | | | | | | | | | |
| SUBMITTED BY | SANJEEV PANDEY |  | | | | | | | | | | | | | | | | | | | | | | | | | | | | |

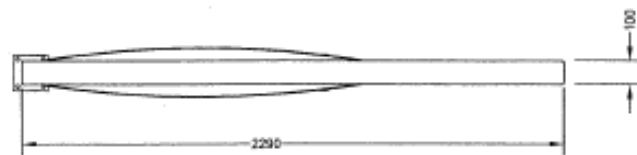

PLAN

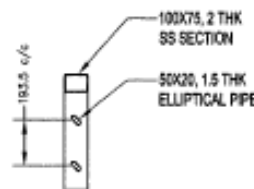


SECTION-AA

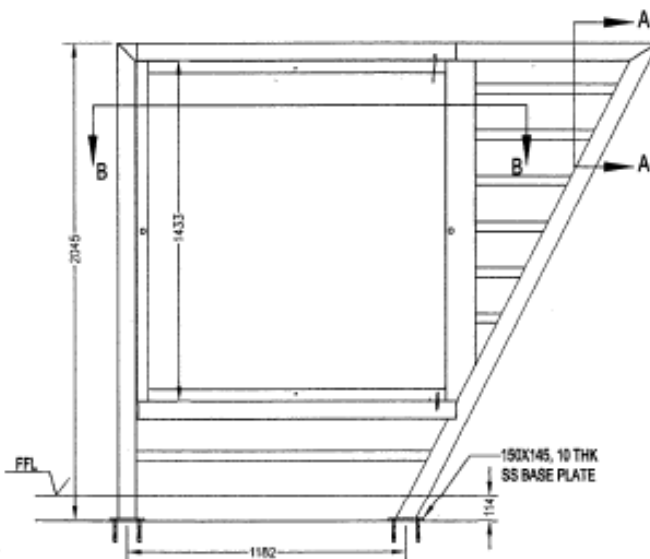


ELEVATION

SCALE 1:20

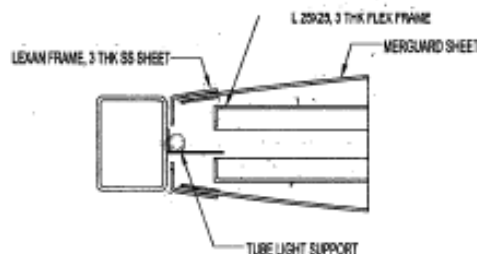


DETAIL-C

SCALE 1:5

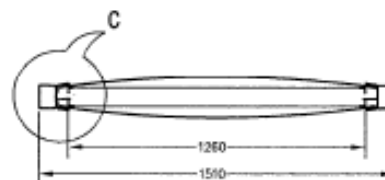

SECTION-BB


SCALE 1:20

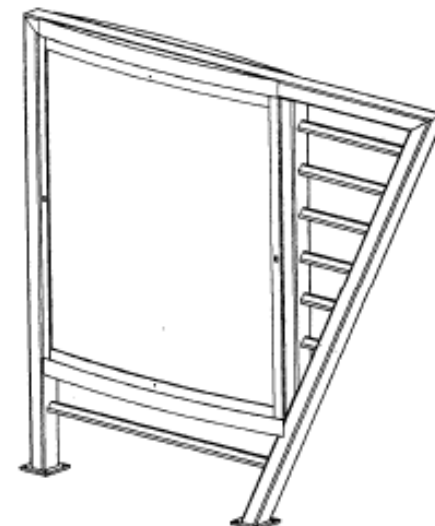






ISOMETRIC VIEW

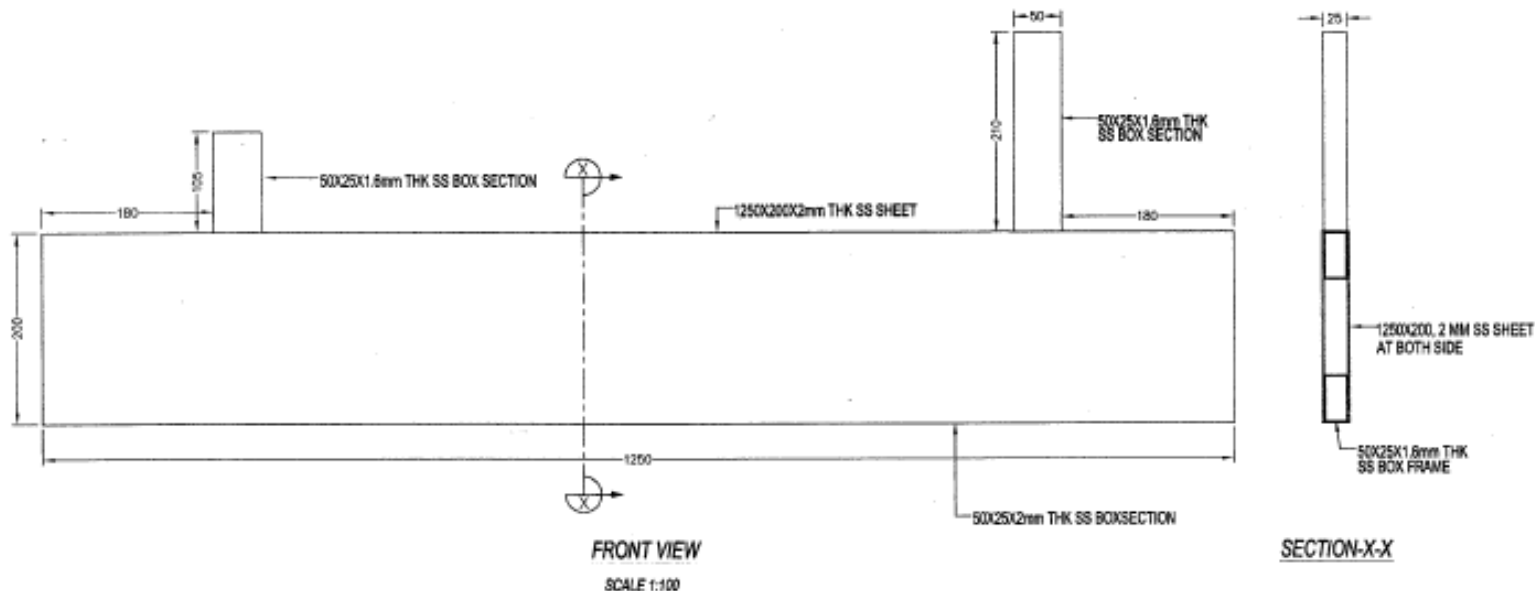NOTE- ALL DIMENSIONS IN mm OR STATED OTHERWISE


| PLANNING / DESIGN | PROJECT MANAGEMENT CONSULTANT | CONTRACTOR | DRG. TITLE: BQS STRUCTURE- SIDE PANEL | TRANSPORT DEPARTMENT | |
|---|--|-------------------------------------|---|---------------------------|---|
| INDIAN INSTITUTE OF TECHNOLOGY, HAUZ KHAS NEW DELHI- 110016 | BITES LIMITED (Schedule "A" Enterprise of Govt. of India) TRANSPORT INFRASTRUCTURE DIVISION BITES BHAWAN, PLOT NO.1 SECTOR-28, GURGAON-122001 (HARYANA) Website: www.rites.com | JINDAL Architecture Ltd. | DRAWING NO:- JAL/BRT/AN-DG/BQS(PKG-1)/AS-BUILT/5 | (GOVERNMENT OF NCT DELHI) | DIMTS LTD. |
| | NAME CHECKED BY SATYENDRA, MGR / TI APPROVED BY S.S. SEHRAWAT, AGM / TI | SIGNATURE | NAME:- CHECKED BY PANKAJ SAXENA SUBMITTED BY SANJEEV PANDEY | SIGNATURE | SHEET NO:- 5 of 6 DATE:- 28/01/2009 SCALE :- Mentioned with Elements |
| | | | | | Project Title : CONSTRUCTION WORKS RELATED TO BUS STATION ON HIGH CAPACITY BUS SYSTEM ON AMBEDKAR NAGAR-DELHI GATE CORRIDOR IN DELHI (PACKAGE-1: AMBEDKAR NAGAR Jm. - PRESS ENCLAVE Jm.) |




| PLANNING / DESIGN | PROJECT MANAGEMENT CONSULTANT | CONTRACTOR | DRG. TITLE: WELCOME BOARD | TRANSPORT DEPARTMENT (GOVERNMENT OF NCT DELHI) |  DIMTS LTD. |
|--|---|--|---|--|--|
|  INDIAN INSTITUTE OF TECHNOLOGY, HAUZ KHAS NEW DELHI- 110016 |  RITES LIMITED (Schedule "A" Enterprise of Govt of India) TRANSPORT INFRASTRUCTURE DIVISION RITES BHAWAN, PLOT NO.1 SECTOR-28, GURGAON-122051 (HARYANA) Website:- www.rites.com |  JINDAL Architecture Ltd. | DRAWING NO:- JAL/BRT/IAN-DG/BQS/PKG-1/AS-BUILT/6 | Project Title : CONSTRUCTION WORKS RELATED TO BUS STATION ON HIGH CAPACITY BUS SYSTEM ON AMBEDKAR NAGAR-DELHI GATE CORRIDOR IN DELHI (PACKAGE-1: AMBEDKAR NAGAR Jn. - PRESS ENCLAVE Jn.) | |
| CHECKED BY SATYENDRA, MOR / TI | CHECKED BY R.N. SINGH, AM / TI | PREPARED BY VIVEK TRIPATHI | SHEET NO:- 1 of 1 | | |
| APPROVED BY B.S. SEHRAWAT, AGM / TI | APPROVED BY B.S. SEHRAWAT, AGM / TI | CHECKED BY PANKAJ SAXENA | DATE:- 28/01/2009 | | |
| | | SUBMITTED BY SANJEEV PANDEY | SCALE :- 1:5 | | |

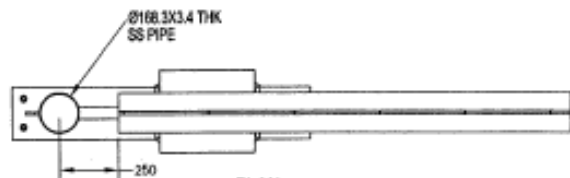


PLAN

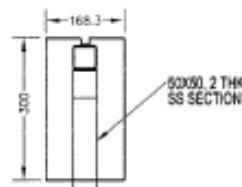


DETAIL - Q
SCALE 1:10

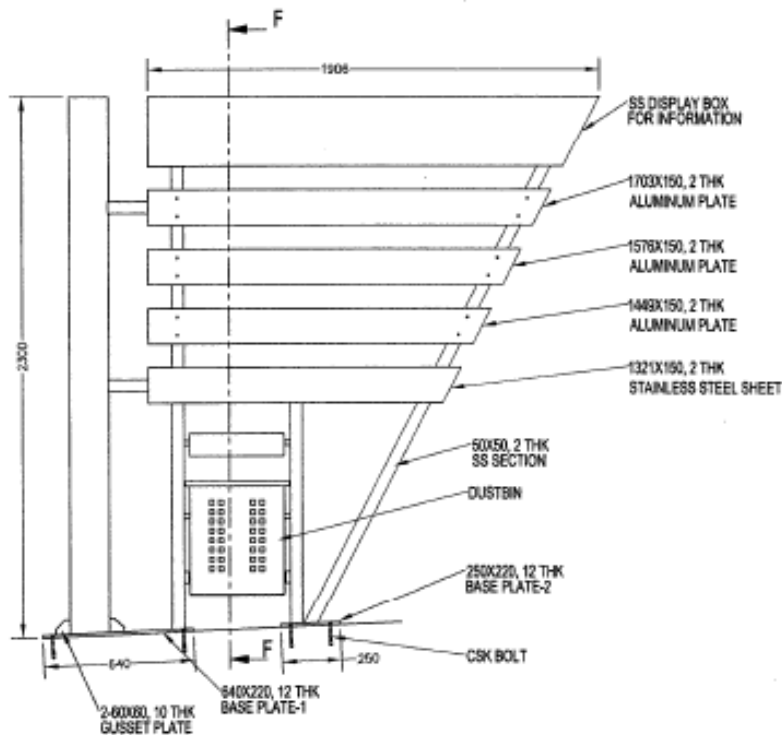


ELEVATION
SCALE 1:20

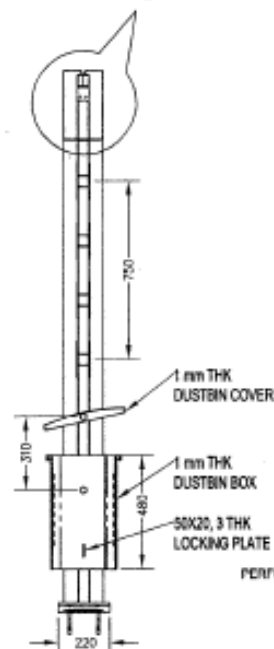

SECTION - FF
SCALE 1:20

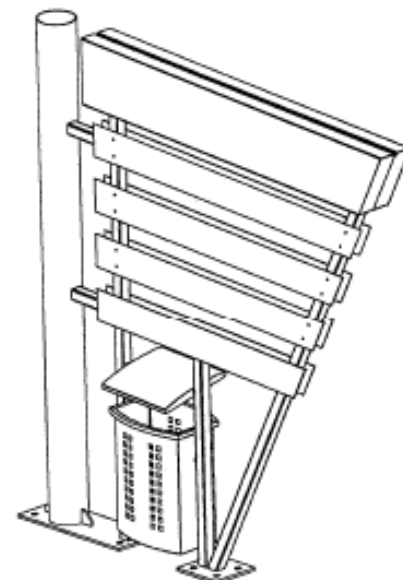

ISOMETRIC VIEW

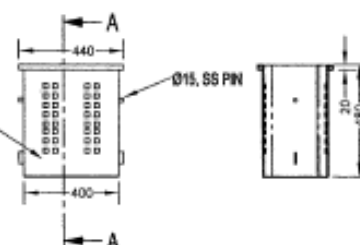





FRONT VIEW

SECTION A-A

DUSTBIN DETAIL
SCALE 1:20


NOTE- ALL DIMENSIONS IN mm OR STATED OTHERWISE

| PLANNING / DESIGN | PROJECT MANAGEMENT CONSULTANT | CONTRACTOR | DRG. TITLE: INFORMATION BOARD WITH DUSTBIN | TRANSPORT DEPARTMENT (GOVERNMENT OF NCT DELHI) | DIMITS LTD. |
|---|---|-------------------------------------|---|---|-------------|
| INDIAN INSTITUTE OF TECHNOLOGY, HAUZKHAS NEW DELHI- 110016 | BITES LIMITED <i>(Schedule "A" Enterprise of Govt of India)</i> TRANSPORT INFRASTRUCTURE DIVISION BITES BHAWAN, PLOT NO.1 SECTOR-29, GURGAON-122001 (HARYANA) <i>Website:- www.rites.com</i> | JINDAL Architecture Ltd. | DRAWING NO:- JAL/BRT/AN-DG/BQS(PKG-1)AS-BUILT/7 | Project Title : CONSTRUCTION WORKS RELATED TO BUS STATION ON HIGH CAPACITY BUS SYSTEM ON AMBEDKAR NAGAR-DELHI GATE CORRIDOR IN DELHI (PACKAGE-1: AMBEDKAR NAGAR Jn. - PRESS ENCLAVE Jn.) | |
| | NAME R.N. SINGH, AM / TI SATYENDRA, MOR / TI APPROVED BY B.S. SEHRAWAT, AGM / TI | SIGNATURE | NAME:- VIVEK TRIPATHI PANKAJ SAXENA SANJEEV PANDEY | SIGNATURE | |
| | | | SHEET NO:- 1 of 1 DATE:- 28/01/2009 SCALE :- Mentioned with Elements | | |

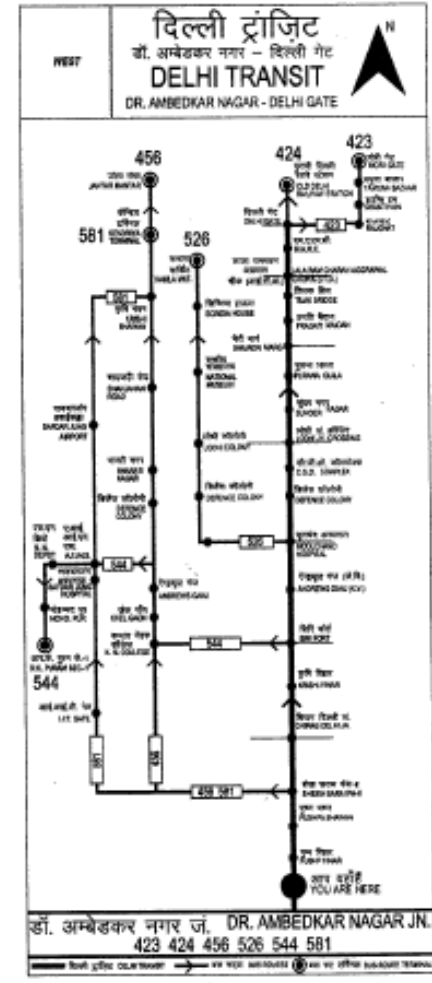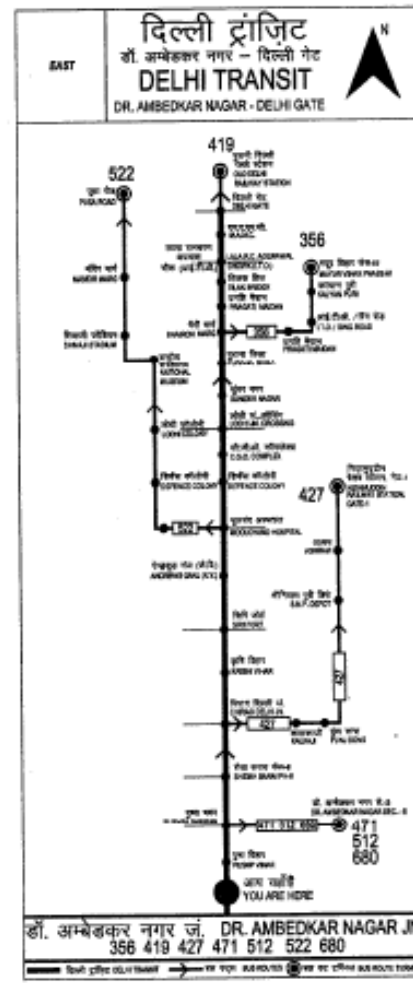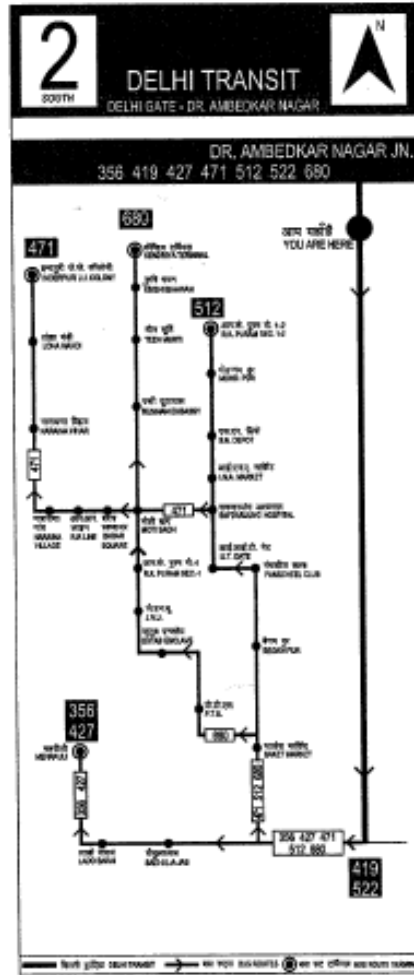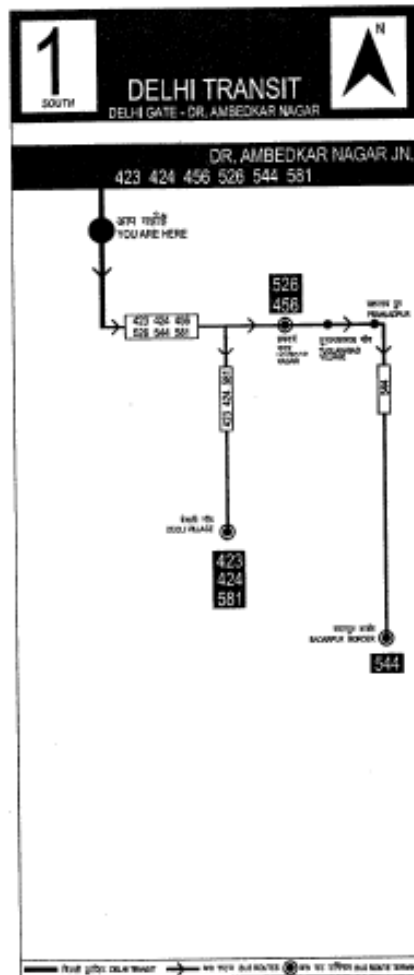


SUN-BOARD OF SIZE:- 580 mm X 1415 mm X 5 mm


| PLANNING / DESIGN | PROJECT MANAGEMENT CONSULTANT | CONTRACTOR | DRG. TITLE: ROUTE MAP ON SUNBOARD | TRANSPORT DEPARTMENT |
|---|--|---|---|--|
| INDIAN INSTITUTE OF TECHNOLOGY, HAUZ KHAS NEW DELHI- 110016 | RITES LIMITED (Solely a "A" Enterprise of Govt. of India) TRANSPORT INFRASTRUCTURE DIVISION RITES BHAWAN, PLOT NO.1 SECTOR-29, GURGAON-122001 (HARYANA) Website:- www.rites.com | JINDAL Architecture Ltd. | DRAWING NO:- JAL/BRT/AN-DG/9QS/PKG-1/VAS-BULT/19 SHEET NO:- 1 of 5 DATE:- 28/01/2009 SCALE :- 1:7 | GOVERNMENT OF NCT DELHI Project Title : CONSTRUCTION WORKS RELATED TO BUS STATION ON HIGH CAPACITY BUS SYSTEM ON AMBEDKAR NAGAR-DELHI GATE CORRIDOR IN DELHI (PACKAGE-1: AMBEDKAR NAGAR Jn. - PRESS ENCLAVE Jn.) |
| | NAME CHECKED BY: R.N. SINGH, AM / TI CHECKED BY: SATYENDRA, MGR / TI APPROVED BY: B.S. SEHRAWAT, AGM / TI | NAME:- VIVEK TRIPATHI PANKAJ SAXENA SANJEEV PANDEY | | DIMTS LTD. |

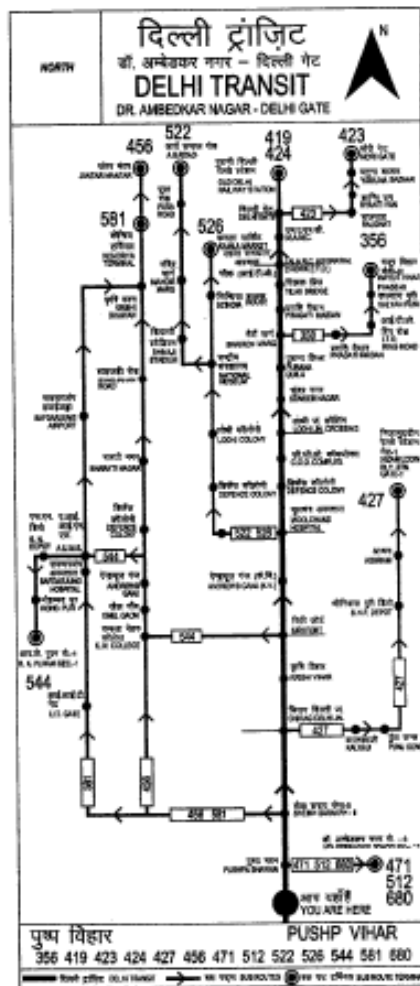


(3 Nos.)

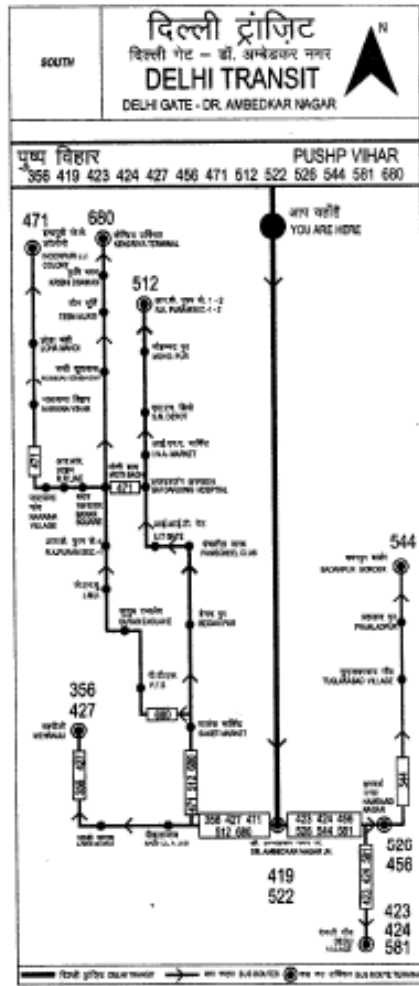

(3 Nos.)

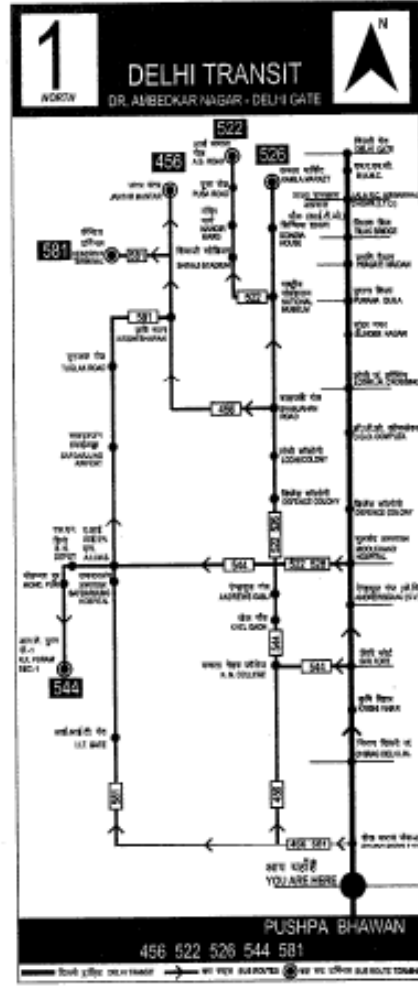

(2 Nos.)

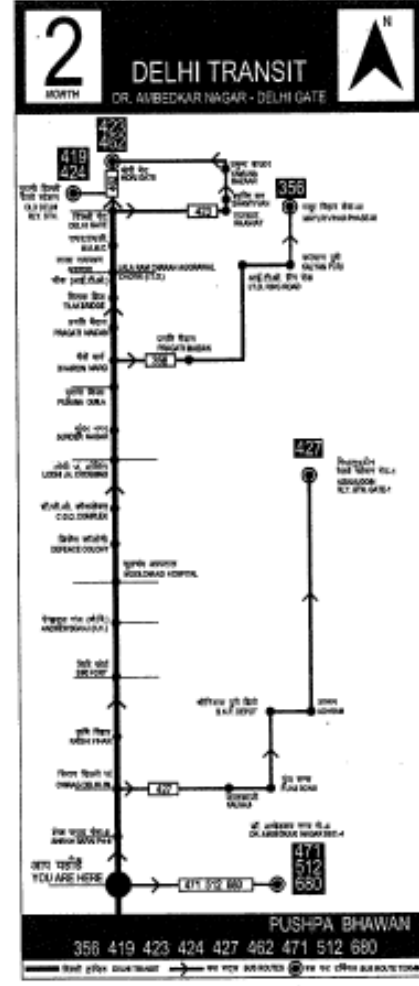

(2 Nos.)

SUN-BOARD OF SIZE:- 580 mm X 1415 mm X 5 mm

| PLANNING / DESIGN | | PROJECT MANAGEMENT CONSULTANT | | CONTRACTOR | | DRG. TITLE: ROUTE MAP ON SUNBOARD | |
|--|--|--|--|--------------------------------|--|--|--|
| INDIAN INSTITUTE OF TECHNOLOGY, HAUZ KHAS NEW DELHI-110016 | | RITES LIMITED (Solely "A" Enterprise of Govt. of India) TRANSPORT INFRASTRUCTURE DIVISION RITES BHAWAN, PLOT NO.1 SECTOR-28, GURGAON-122001 (HARYANA) Website:- www.rites.com | | JINDAL Architecture Ltd. | | DRAWING NO:- JAL/BRTIAN-DG/BQS(PKG-1)/AS-BUILT/10 | |
| CHECKED BY SATYENDRA, MGR / TI | | NAME R.N. SINGH, AM / TI | | PREPARED BY VIVEK TRIPATHI | | SHEET NO:- 2 of 5 | |
| APPROVED BY B.S. SEHRAWAT, AGM / TI | | SIGNATURE | | CHECKED BY PANKAJ SAXENA | | DATE:- 28/01/2009 | |
| | | | | SUBMITTED BY SANJEEV PANDEY | | SCALE :- 1:1 | |

**TRANSPORT
DEPARTMENT**


(GOVERNMENT OF NCT DELHI)




DIMTS LTD.

Project Title :


CONSTRUCTION WORKS RELATED TO BUS STATION ON HIGH CAPACITY
BUS SYSTEM ON AMBEDKAR NAGAR-DELHI GATE CORRIDOR IN DELHI
(PACKAGE-1: AMBEDKAR NAGAR Jn. - PRESS ENCLAVE Jn.)

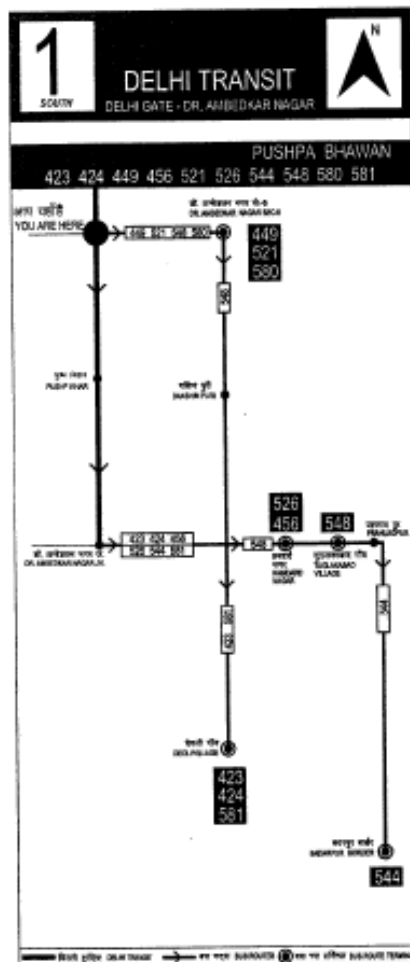


(2 Nos.)

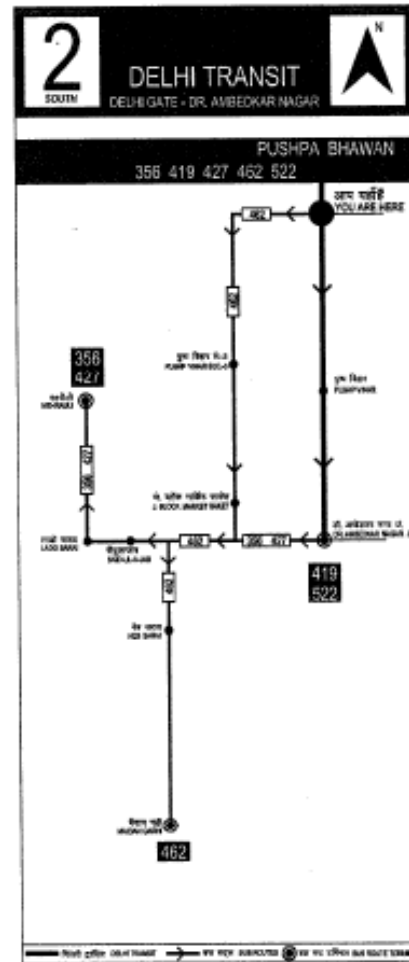

(2 Nos.)

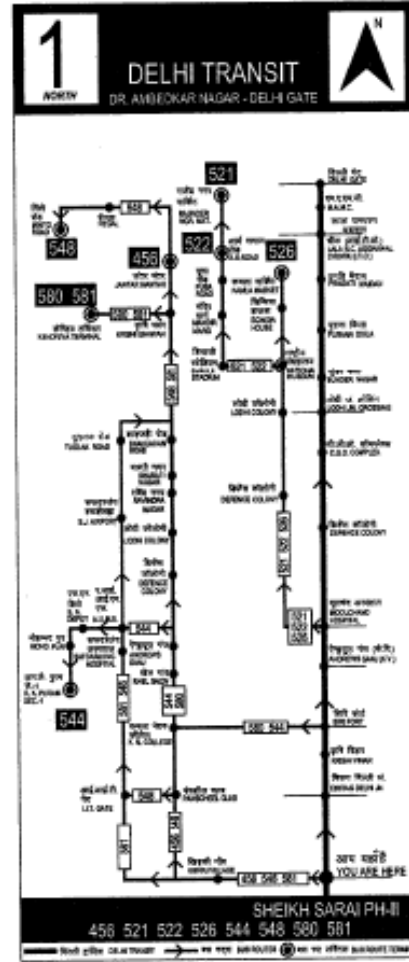



(2 Nos.)

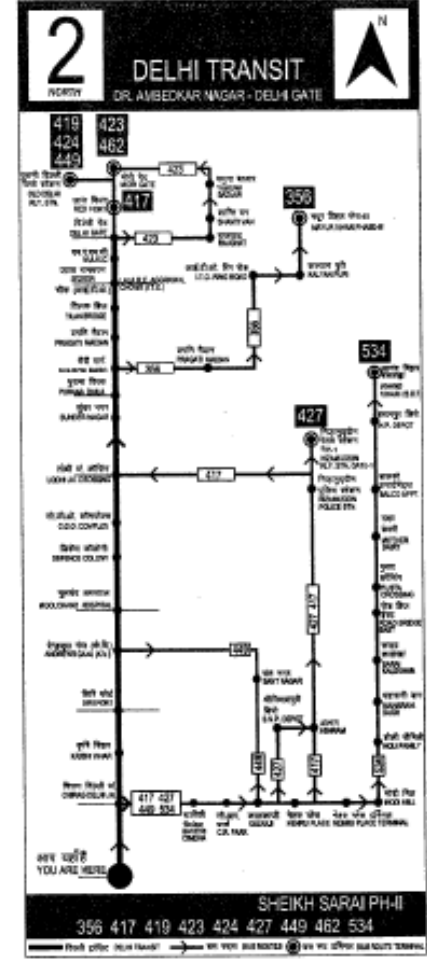






(2 Nos.)

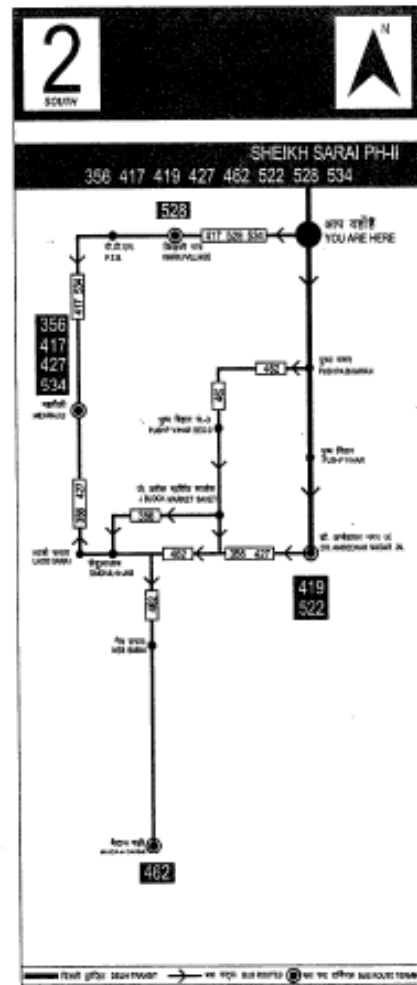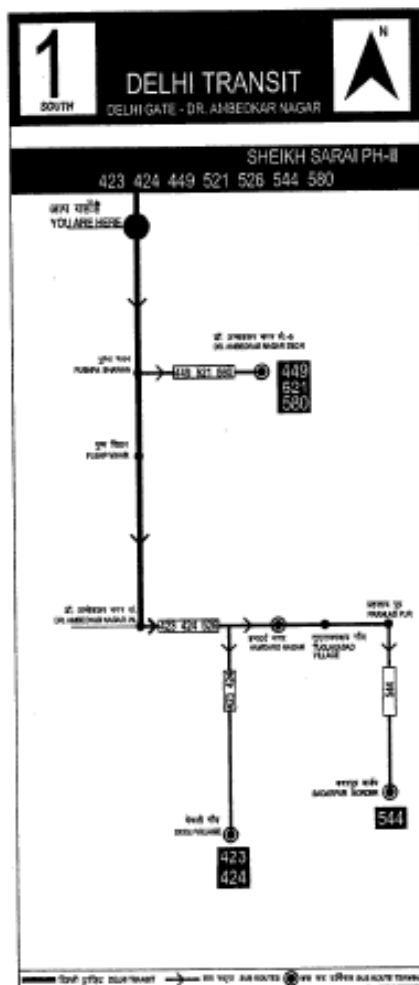
SUN-BOARD OF SIZE:- 580 mm X 1415 mm X 5 mm

| PLANNING / DESIGN | PROJECT MANAGEMENT CONSULTANT | CONTRACTOR | DRG. TITLE: ROUTE MAP ON SUNBOARD | TRANSPORT DEPARTMENT (GOVERNMENT OF NCT DELHI) | DIMTS LTD. |
|--|--|---------------------------------|---|--|--|
| TRIPP INDIAN INSTITUTE OF TECHNOLOGY, HAUZKHAS NEW DELHI- 110016 | RITES LIMITED (Schedule "A" Enterprise of Govt of India) TRANSPORT INFRASTRUCTURE DIVISION RITES BHAWAN, PLOT NO.1 SECTOR-29, GURGAON-122001 (HARYANA) Website:- www.rites.com | JINDAL Architecture Ltd. | DRAWING NO:- JAL/BRTIAN-DG/BQS(PKG-1)/AS-BUILT/10 | Project Title : CONSTRUCTION WORKS RELATED TO BUS STATION ON HIGH CAPACITY BUS SYSTEM ON AMBEDKAR NAGAR-DELHI GATE CORRIDOR IN DELHI (PACKAGE-1: AMBEDKAR NAGAR Jn. - PRESS ENCLAVE Jn.) | |
| | NAME CHECKED BY CHECKED BY APPROVED BY | SIGNATURE | NAME:- VIVEK TRIPATHI PANKAJ SAXENA SANJEEV PANDEY | SIGNATURE | SHEET NO:- 3 of 5 DATE:- 28/01/2009 SCALE :- 1:7 |





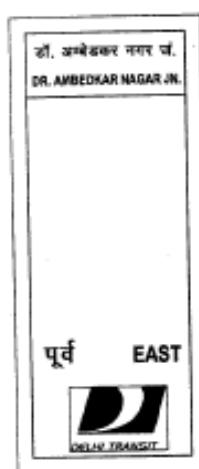

SUN-BOARD OF SIZE:- 580 mm X 1415 mm X 5 mm

| | | | | | | | | | | | |
|---|--|---|--|---|--|--|--|---|--|---|--|
| PLANNING / DESIGN | | PROJECT MANAGEMENT CONSULTANT | | CONTRACTOR | | DRG. TITLE: ROUTE MAP ON SUNBOARD | | TRANSPORT DEPARTMENT | |  | |
|  INDIAN INSTITUTE OF TECHNOLOGY, HAUZ KHAS NEW DELHI- 110016 | |  RITES LIMITED (Schedule "A" Enterprise of Govt. of India) TRANSPORT INFRASTRUCTURE DIVISION RITES SHAWAN, PLOT NO.1 SECTOR-28, GURGAON-122001 (HARYANA) Website:- www.rites.com | |  JINDAL Architecture Ltd. | | DRAWING NO:- JAL/BRTIAN-DG/BQS(PKG-1)/AS-BUILT/10 | | (GOVERNMENT OF NCT DELHI) | | DIMTS LTD. | |
| CHECKED BY SATYENDRA, MGR / TI | | NAME R.N. SINGH, AM / TI | | NAME:- VIVEK TRIPATHI | | SHEET NO:- 4 of 5 | | Project Title : CONSTRUCTION WORKS RELATED TO BUS STATION ON HIGH CAPACITY BUS SYSTEM ON AMBEDKAR NAGAR-DELHI GATE CORRIDOR IN DELHI (PACKAGE-1: AMBEDKAR NAGAR Jn. - PRESS ENCLAVE Jn.) | | | |
| APPROVED BY B.S. SEHRAWAT, AGM / TI | | SIGNATURE  | | CHECKED BY PANKAJ SAXENA | | DATE:- 28/01/2009 | | | | | |
| | | | | SUBMITTED BY SANJEEV PANDEY | | SCALE > 1:1 | | | | | |



INFORMATION ON BACK SIDE OF SUNBOARDS AT RESPECTIVE BUS STATIONS

| PLANNING / DESIGN | PROJECT MANAGEMENT CONSULTANT | CONTRACTOR | DRG. TITLE: ROUTE MAP ON SUNBOARD | TRANSPORT DEPARTMENT (GOVERNMENT OF NCT DELHI) |  DIMTS LTD. |
|---|--|--|---|--|---|
|  INDIAN INSTITUTE OF TECHNOLOGY, HAUZ KHAS NEW DELHI- 110016 |  BITES LIMITED (Schedule "A" Enterprise of Govt. of India) TRANSPORT INFRASTRUCTURE DIVISION BITES BHAWAN, PLOT NO.1 SECTOR-39, GURGAON-122001 (HARYANA) Website:- www.rites.com |  JINDAL Architecture Ltd. | DRAWING NO:- JAL/DR/AN-DG/BQS(PKG-1)/AS-BUILT/10 | Project Title : CONSTRUCTION WORKS RELATED TO BUS STATION ON HIGH CAPACITY BUS SYSTEM ON AMBEDKAR NAGAR-DELHI GATE CORRIDOR IN DELHI (PACKAGE-1: AMBEDKAR NAGAR Jn. - PRESS ENCLAVE Jn.) | |
| | NAME: R.N. SINGH, AM/ TI | NAME:- VIVEK TRIPATHI | SHEET NO:- 5 of 5 | | |
| | CHECKED BY: SATYENDRA, MGR / TI | CHECKED BY: PANKAJ SAXENA | DATE:- 28/01/2009 | | |
| | APPROVED BY: B.S. SEHRAWAT, AGM / TI | SUBMITTED BY: SANJEEV PANDEY | SCALE :- 1:15 | | |

| दिल्ली ट्रांजिट डॉ. अम्बेडकर नगर जं.-पूर्व AMBEDKAR NAGAR JN - EAST |
|---|
| 356 419 427 471 |
| 512 522 680 |

TEMP-1, 3 Nos.

| दिल्ली ट्रांजिट डॉ. अम्बेडकर नगर जं.-पश्चिम AMBEDKAR NAGAR JN - WEST |
|--|
| 423 424 456 526 |
| 544 581 |

TEMP-2, 2 Nos.

| दिल्ली ट्रांजिट डॉ. अम्बेडकर नगर जं.-दक्षिण AMBEDKAR NAGAR JN - SOUTH |
|---|
| 423 424 456 526 |
| 544 581 |
| 356 419 427 471 |
| 512 522 680 |

TEMP-3, 3 Nos.

| दिल्ली ट्रांजिट पुष्प विहार - उत्तर PUSHP VIHAR - NORTH |
|---|
| 356 419 423 424 |
| 427 456 471 512 |
| 522 526 544 581 |
| 680 |

TEMP-4, 2 Nos.

| दिल्ली ट्रांजिट पुष्प विहार - दक्षिण PUSHP VIHAR - SOUTH |
|--|
| 356 419 423 424 |
| 427 456 471 512 |
| 522 526 544 581 |
| 680 |

TEMP-5, 2 Nos.

| दिल्ली ट्रांजिट पुष्पा भवन - उत्तर PUSHPA BHAWAN - NORTH |
|--|
| 456 522 526 544 |
| 581 |
| 356 419 423 424 427 |
| 462 471 512 680 |

TEMP-6, 2 Nos.

| दिल्ली ट्रांजिट पुष्पा भवन - दक्षिण PUSHPA BHAWAN - SOUTH |
|---|
| 423 424 449 456 521 |
| 526 544 548 580 581 |
| 356 419 427 462 |
| 522 |

TEMP-7, 2 Nos.





| दिल्ली ट्रांजिट शेख सराय फेज-2 - उत्तर SHEIKH SARAI PH-2 - NORTH |
|--|
| 456 521 522 526 544 |
| 548 580 581 |
| 356 417 419 423 424 |
| 427 449 462 534 |

TEMP-8, 2 Nos.

| दिल्ली ट्रांजिट शेख सराय फेज-2 - दक्षिण SHEIKH SARAI PH-2 - SOUTH |
|---|
| 423 424 449 521 |
| 526 544 580 |
| 356 417 419 427 462 |
| 522 526 534 |


TEMP-9, 2 Nos.

TEMPORARY SUN-BOARD OF SIZE:- 600 mm X 525 mm X 5 mm


| PLANNING / DESIGN | PROJECT MANAGEMENT CONSULTANT | CONTRACTOR | DRG.TITLE: TEMPORARY SUNBOARD MOUNTED ON POLES | TRANSPORT DEPARTMENT (GOVERNMENT OF NCT DELHI) |  DIMTS LTD. |
|---|--|---|--|---|---|
|  INDIAN INSTITUTE OF TECHNOLOGY,HAUKHSA NEW DELHI- 110016 |  RITES LIMITED (Schedule "A" Enterprise of Govt of India) TRANSPORT INFRASTRUCTURE DIVISION RITES BHAWAN, PLOT NO.1 SECTOR-29, GURGAON-122001 (HARYANA) Website:- www.rites.com |  JINDAL Architecture Ltd. | DRAWING NO:- JALIBRT/AN-DG/008/PKG-1/AS-BUILT/11 | Project Title : CONSTRUCTION WORKS RELATED TO BUS STATION ON HIGH CAPACITY BUS SYSTEM ON AMBEDKAR NAGAR-DELHI GATE CORRIDOR IN DELHI (PACKAGE-1: AMBEDKAR NAGAR Jn. - PRESS ENCLAVE Jn.) | |
| CHECKED BY | R.N. SINGH, AM / TI | PREPARED BY | NAME:- VIVEK TRIPATHI | SHEET NO:- 1 of 1 | |
| CHECKED BY | SATYENDRA, MGR / TI | CHECKED BY | PANKAJ SAXENA | DATE:- 28/11/2009 | |
| APPROVED BY | B.S.SEHRAWAT, AGM / TI | SUBMITTED BY | SANJEEV PANDEY | SCALE :- 1:10 | |

DELHI TRANSIT WELCOMES YOU


FRONT SIDE OF WELCOME BOARD AT ALL BUS STATIONS (14 Nos.)

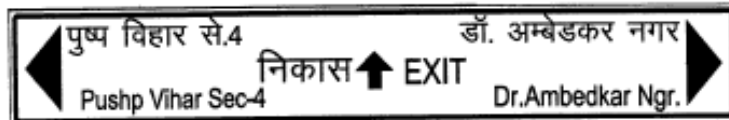


AT PUSHP VIHAR- North (1 No.)

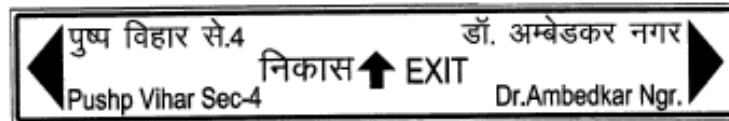


AT PUSHP VIHAR- South (1 No.)

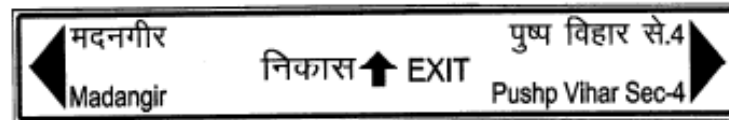


AT PUSHPA BHAWAN- North (2 Nos.)

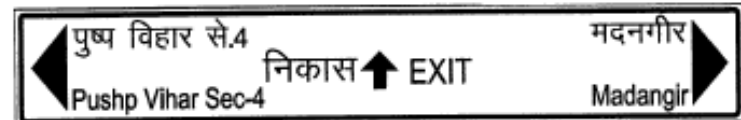

AT PUSHPA BHAWAN- South (2 Nos.)

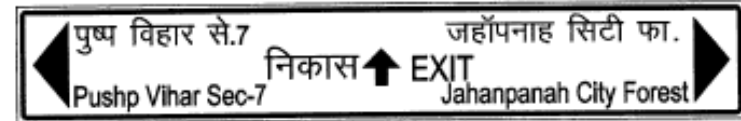

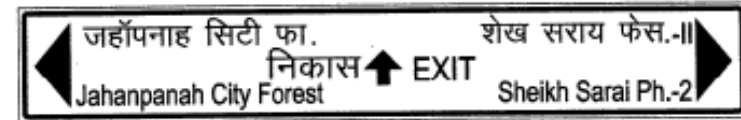


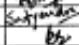
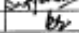





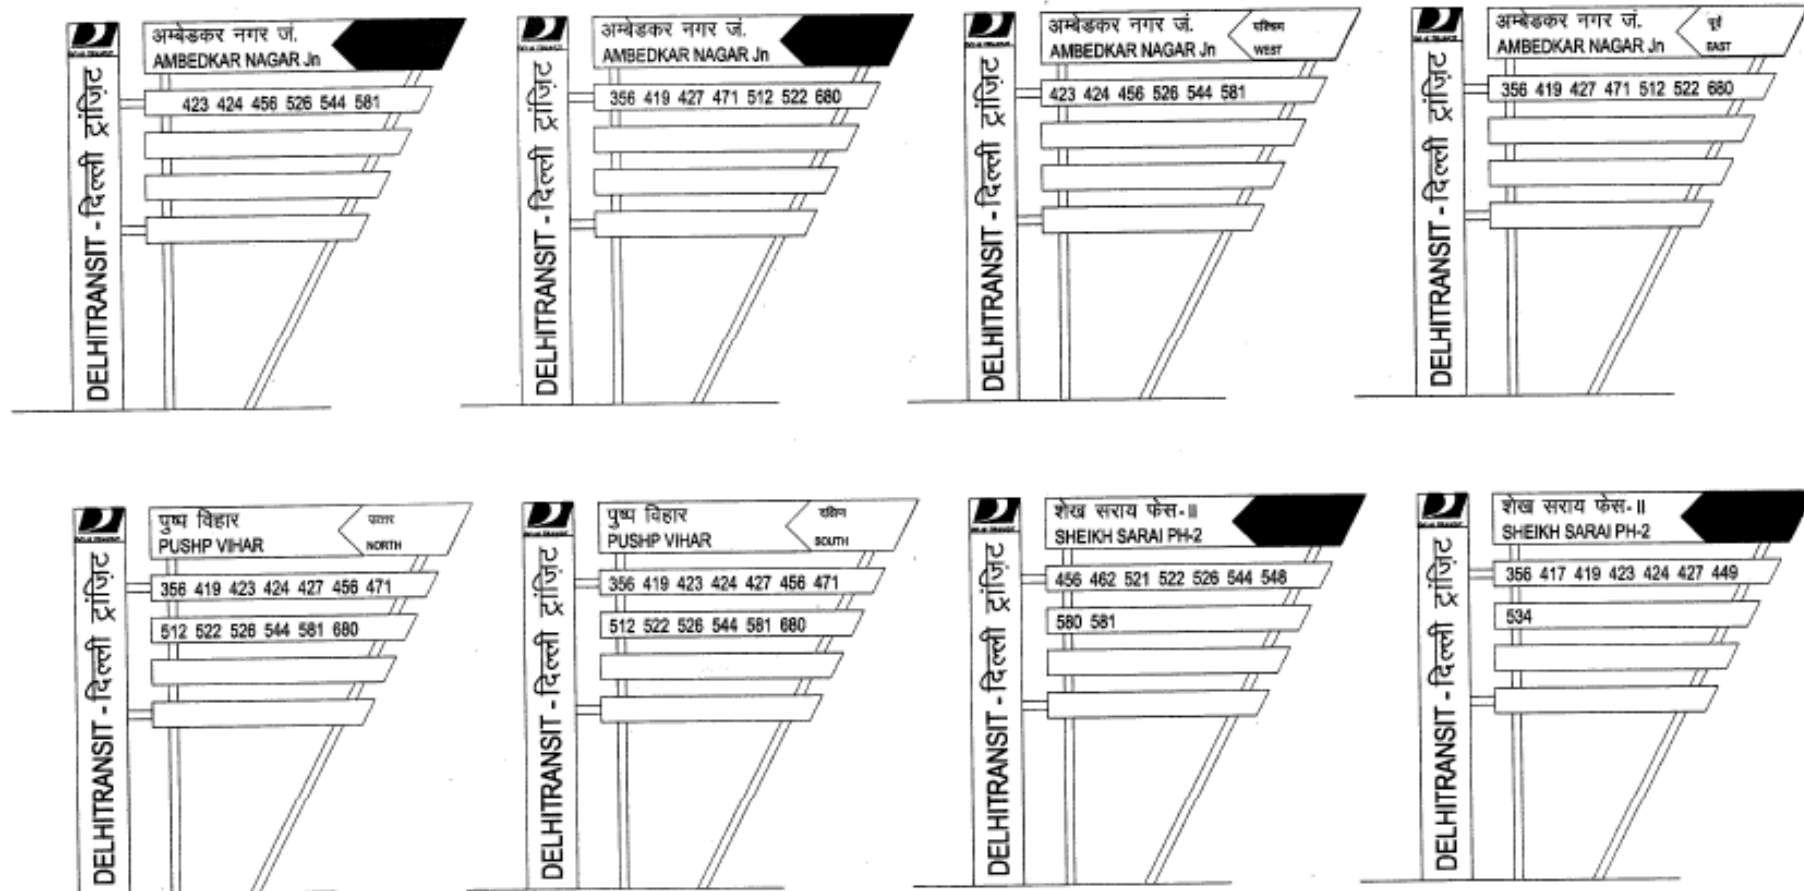
AT SHEIKH SARAI- North (2 Nos.)







AT SHEIKH SARAI- South (2 Nos.)

BACK SIDE OF WELCOME BOARD AT RESPECTIVE BUS STATIONS

| PLANNING / DESIGN | PROJECT MANAGEMENT CONSULTANT | CONTRACTOR | DRG. TITLE: STICKER ON WELCOME BOARD | TRANSPORT DEPARTMENT (GOVERNMENT OF NCT DELHI) |  DIMTS LTD. |
|---|---|---|--|---|--|
|  INDIAN INSTITUTE OF TECHNOLOGY, HAUZ KHAS NEW DELHI- 110016 |  RITES LIMITED (Schedule 'A' Enterprise of Govt. of India) TRANSPORT INFRASTRUCTURE DIVISION RITES BHAWAN, PLOT NO.1 SECTOR-29, GURGAON-122001 (HARYANA) Website:- www.rites.com |  JINDAL Architecture Ltd. | DRAWING NO:- JAL/BRTJAN-DG/BSQ/(PKG-1)JAS-BUILT/12 SHEET NO:- 1 of 1 DATE:- 28/01/2009 SCALE :- 1:8 | Project Title : CONSTRUCTION WORKS RELATED TO BUS STATION ON HIGH CAPACITY BUS SYSTEM ON AMBEDKAR NAGAR-DELHI GATE CORRIDOR IN DELHI (PACKAGE-1: AMBEDKAR NAGAR Jn. - PRESS ENCLAVE Jn.) | |
| | CHECKED BY CHECKED BY APPROVED BY | NAME R.N. SINGH, AM / TI SATYENDRA, MGR / TI B.S. SEHRAWAT, AGM / TI | SIGNATURE    | NAME VIVEK TRIPATHI PANKAJ SAXENA SANJEEV PANDEY | SIGNATURE    |



| PLANNING / DESIGN | PROJECT MANAGEMENT CONSULTANT | CONTRACTOR | DRG. TITLE: INFORMATION BOARD- SIGNAGE DETAIL | TRANSPORT DEPARTMENT (GOVERNMENT OF NCT DELHI) |  DIMTS LTD. |
|---|---|--|--|--|---|
|  INDIAN INSTITUTE OF TECHNOLOGY, HAUZ KHAS NEW DELHI- 110016 |  RITES LIMITED (Schedule "A" Enterprise of Govt. of India) TRANSPORT INFRASTRUCTURE DIVISION RITES BHAWAN, PLOT NO.1 SECTOR-29, GURGAON-122001 (HARYANA) Website:- www.rites.com |  JINDAL Architecture Ltd. | DRAWING NO:- JAL/BRT/AN-DG/BQS(PKG-1)XAS-BUILT713 | Project Title : CONSTRUCTION WORKS RELATED TO BUS STATION ON HIGH CAPACITY BUS SYSTEM ON AMBEDKAR NAGAR-DELHI GATE CORRIDOR IN DELHI (PACKAGE-1: AMBEDKAR NAGAR Jn. - PRESS ENCLAVE Jn.) | |
| | CHECKED BY R.M. SINGH, AM / TI | CHECKED BY VIVEK TRIPATHI | SHEET NO:- 1 of 2 | | |
| | CHECKED BY SATYENDRA MGR / TI | CHECKED BY PANKAJ SAXENA | DATE:- 28/01/2009 | | |
| | APPROVED BY B.S. SEHRAWAT, AGM / TI | SUBMITTED BY SANJEEV PANDEY | SCALE :- 1:28 | | |